

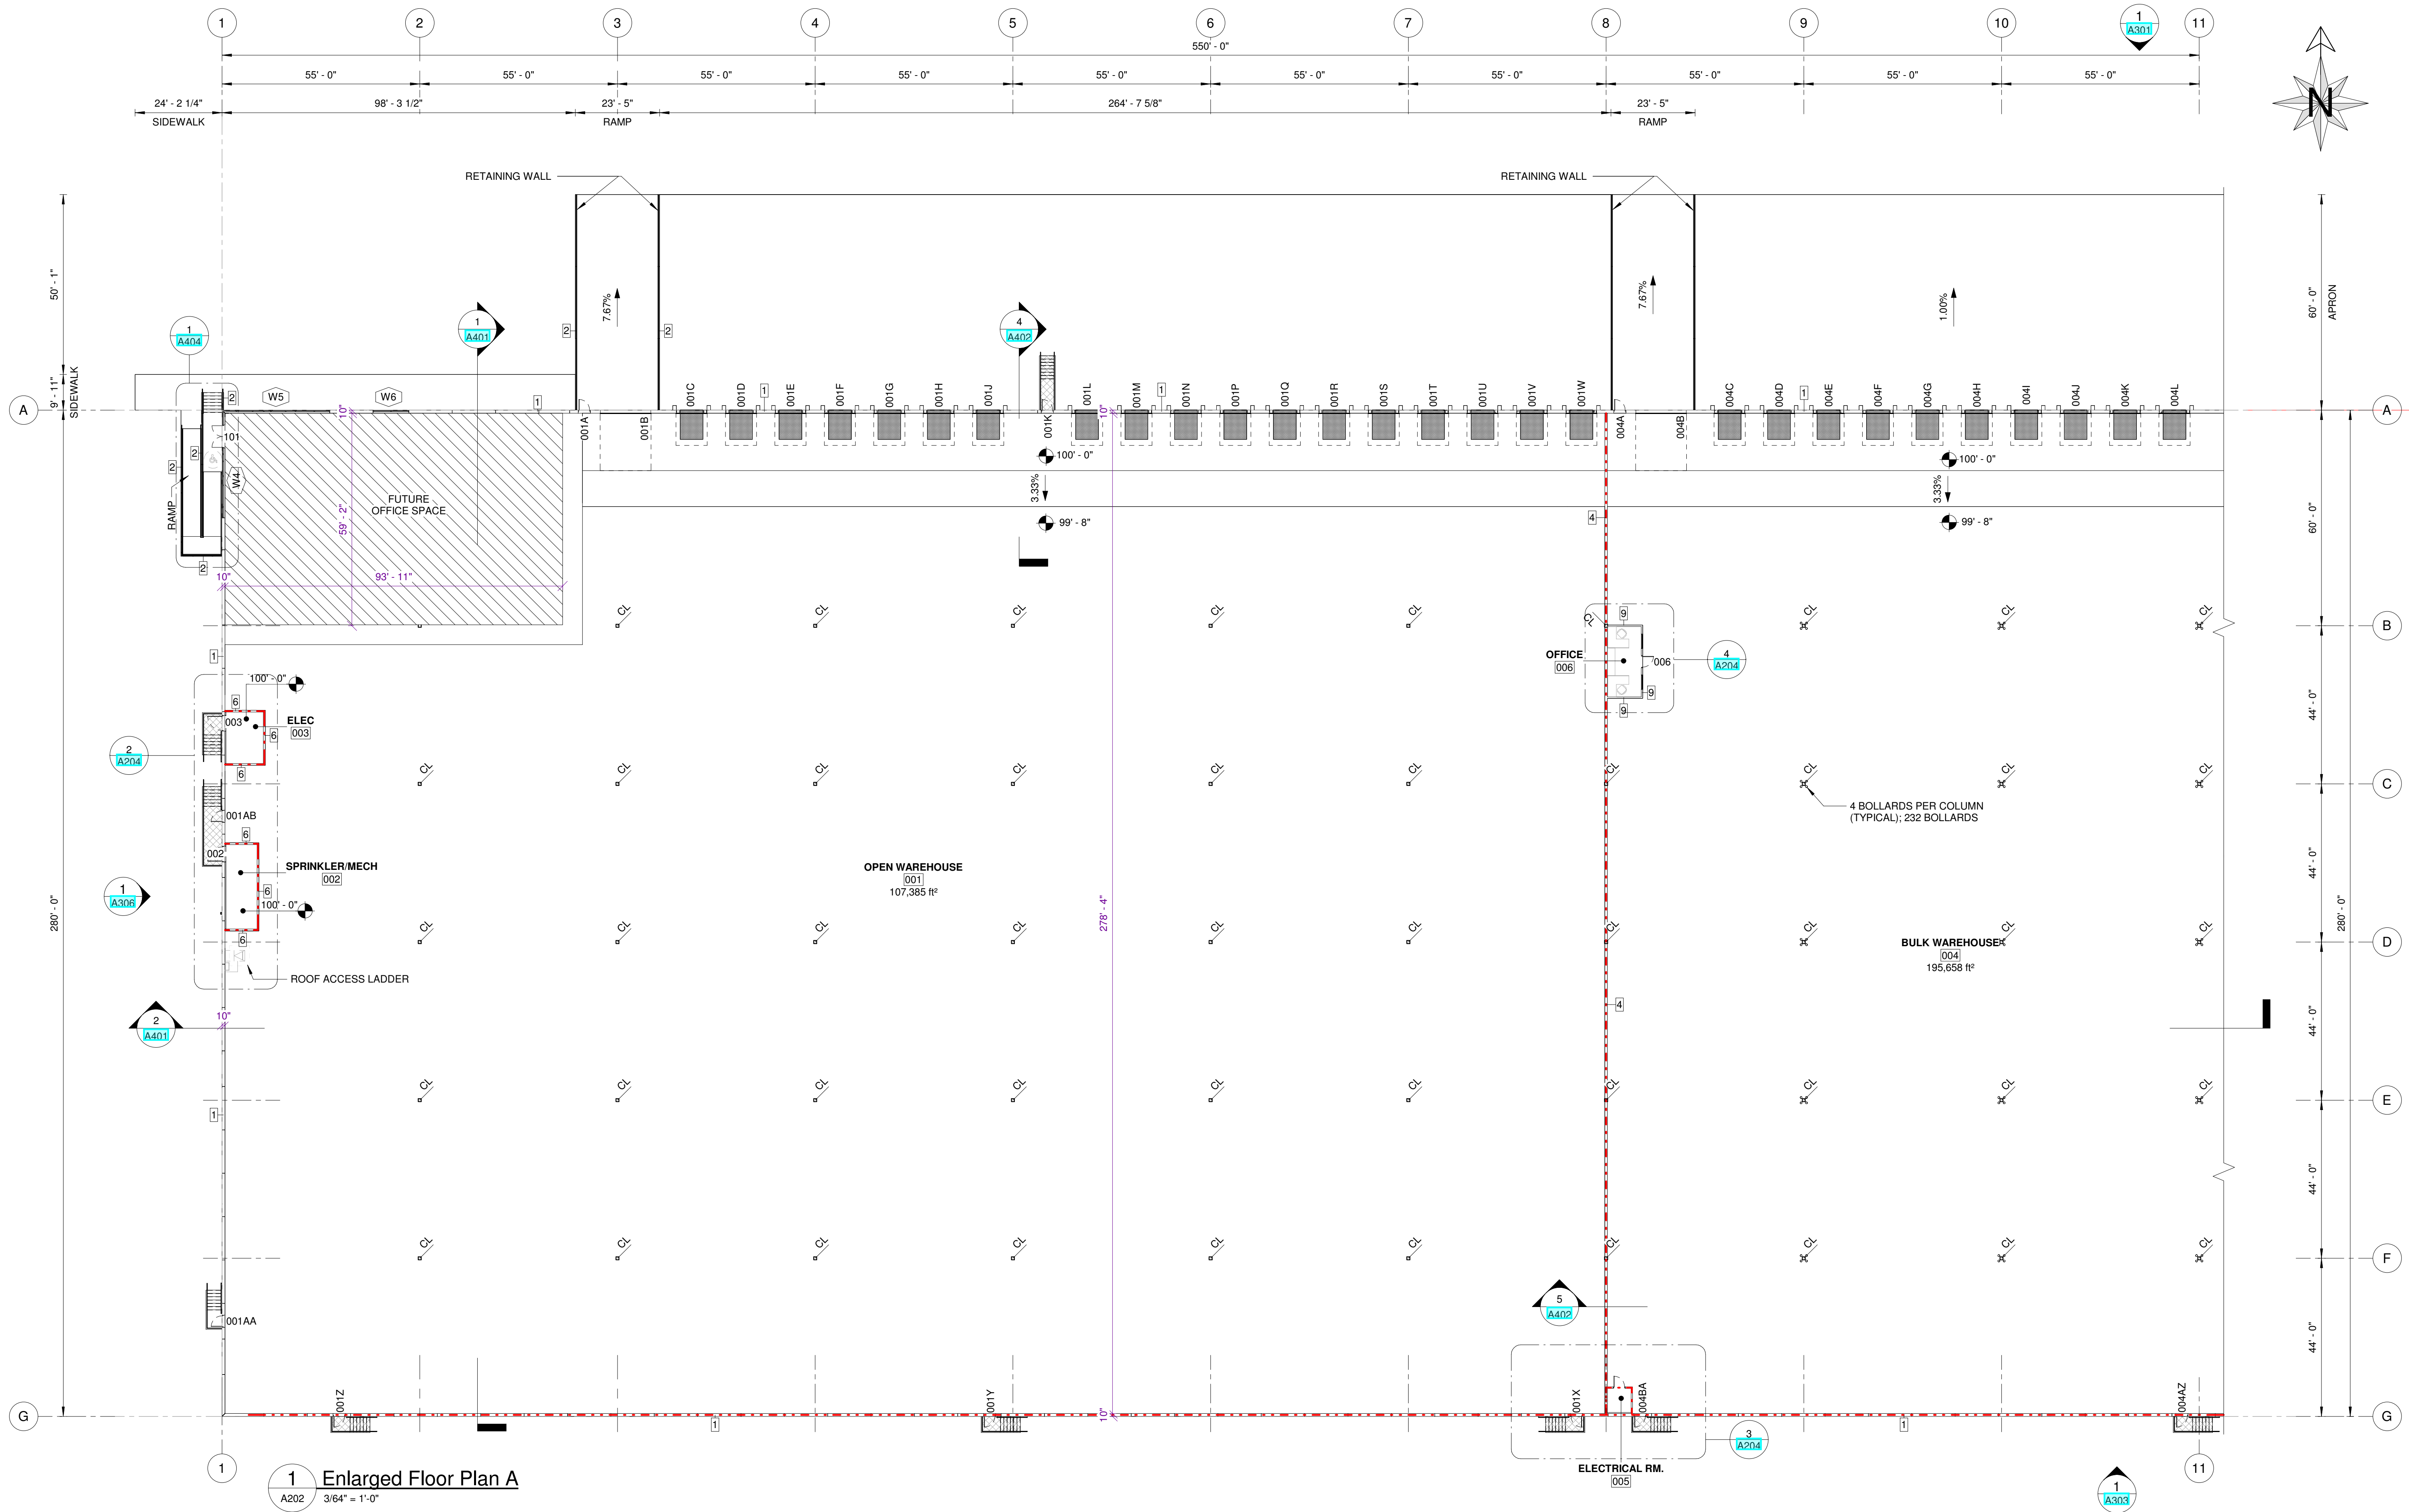
**WALL TYPE SCHEDULE**

- 1 10" INSULATED PRECAST CONCRETE WALL PANEL CW 4" INSULATION (TYPE S CONCRETE: UP TO 2 HR F.R.R. AS PER TABLE D-2.1.1.)
- 2 5.5" SOLID PRECAST CONCRETE WALL PANEL (UP TO 2 HR F.R.R. AS PER TABLE D-2.1.1.)
- 3 5" SOLID PRECAST CONCRETE WALL PANEL

- 4 2 LAYERS 5/8" TYPE "X" GYPSUM BOARD  
6" STEEL STUDS @ 16" O/C  
5 1/2" MINERAL FIBRE BATT INSULATION  
2 LAYERS 5/8" TYPE "X" GYPSUM BOARD (UP TO 2HR FIRE RESISTANCE RATING) (DESIGN NO. ULC W453)  
4" CONCRETE CURB
- 5 2 LAYERS 5/8" TYPE "X" GYPSUM BOARD  
6" STEEL STUDS @ 16" O/C  
5 1/2" MINERAL FIBRE BATT INSULATION  
2 LAYERS 5/8" TYPE "X" GYPSUM BOARD (UP TO 2HR FIRE RESISTANCE RATING) (DESIGN NO. ULC W453)



- 6 2 LAYERS 5/8" TYPE "X" GYPSUM BOARD  
6" STEEL STUDS @ 16" O/C  
3 1/2" MINERAL FIBRE BATT INSULATION  
2 LAYERS 5/8" TYPE "X" GYPSUM BOARD (UP TO 2 HR FIRE RESISTANCE RATING) (DESIGN NO. ULC W453)
- 7 5/8" TYPE "X" GYPSUM BOARD  
3 5/8" STEEL STUDS @ 16" O/C  
3 1/2" MINERAL FIBRE BATT INSULATION  
5/8" TYPE "X" GYPSUM BOARD (UP TO 1 HR FIRE RESISTANCE RATING) (DESIGN NO. ULC W453)

- 8 1/2" GYPSUM BOARD  
6" STEEL STUDS @ 16" O/C  
1/2" GYPSUM BOARD
- 9 1/2" GYPSUM BOARD  
3 5/8" STEEL STUDS @ 16" O/C  
1/2" GYPSUM BOARD
- 10 1 5/8" STEEL STUDS @ 16" O/C  
1/2" GYPSUM BOARD
- 11 1" GAP  
1 5/8" STEEL STUDS @ 16" O/C  
1/2" GYPSUM BOARD



1 Enlarged Floor Plan A  
A202 3/64" = 1'-0"

Architect:  
  
 Stamp:

aggregate  
design studio ltd.  
  
 (403) 885-5525 P.O. BOX 1690  
 BLACKFALDS, AB, T0M 0J0  


**NEXUS**  
**Regina Warehouse**  
 905 Park Street  
 Regina, SK  
 Blk/Par. B, Plan 102245598

NO.	DESCRIPTION	DATE
0	ISSUED FOR CONSTRUCTION	2023-09-06

Project No: S22477  
 Date: 2023-09-06 10:18:57 AM  
 Drawn by: AS, AK, EA  
 Checked by: JK  
 Sheet Name:

Enlarged Floor Plan A  
 Sheet No:  


DO NOT SCALE DRAWING - VERIFY ALL DIMENSIONS, DATUMS AND LEVELS PRIOR TO COMMENCEMENT OF WORK. REPORT ANY DISCREPANCIES OR OMISSIONS TO THE ARCHITECT IMMEDIATELY. ALL WORK MUST COMPLY WITH THE MOST RECENT EDITION OF THE APPLICABLE BUILDING CODE AND ANY OTHER GOVERNING AUTHORITIES. THIS IS A COPYRIGHT DRAWING AND SHALL NOT BE REPRODUCED OR REVISED WITHOUT THE WRITTEN CONSENT OF THE CONSULTANT.